


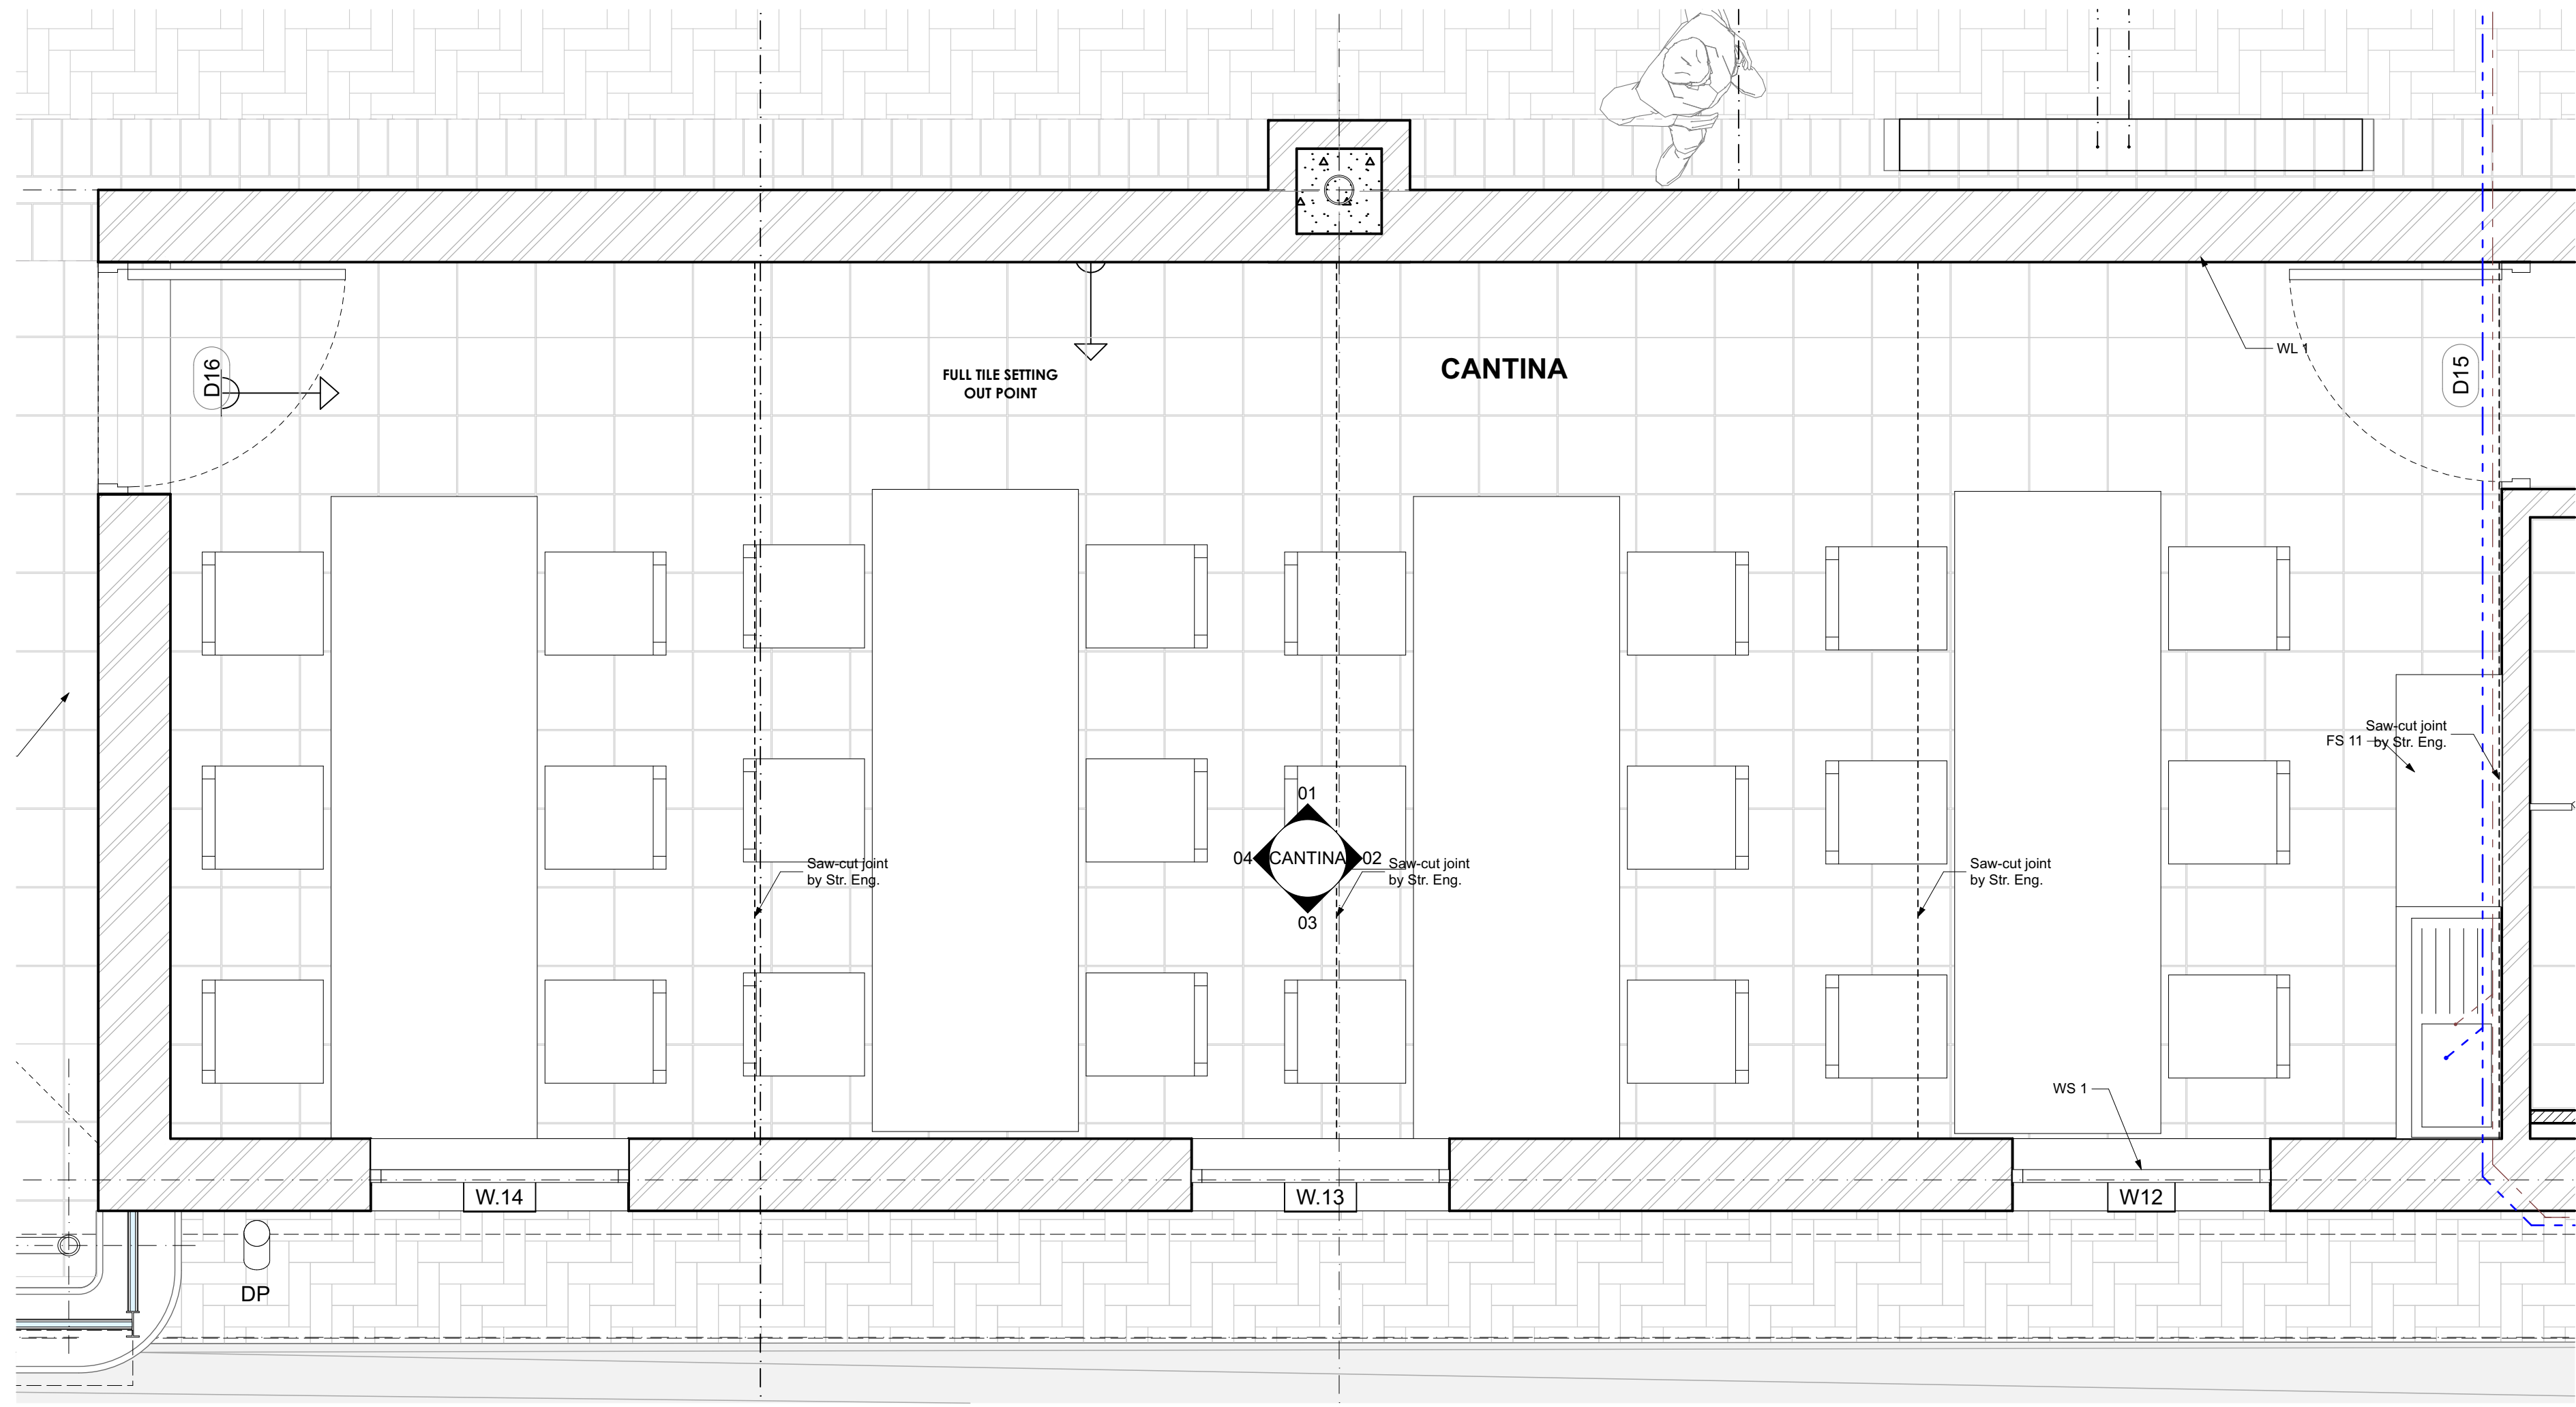


ROOM LAYOUT - CANTINA

1:20

NOTES:
All fire and light fittings to electrical engineers spec.
All Speakers, information boards & cameras to IT consultants spec.
CEILING: See Project Specification - CE 9 - skimmed Rhinoboard
Cornices:
CE 6 - concealed 'shadowline'


NOTES:
This drawing is to be read in conjunction with:
Timber Ceiling Detail:
RRT/AR/CBD21/612

LEGEND	
	Smoke detector
	CCTV camera
	Speaker
	Diffuser
	Digital information board
	Downlight
	Ceiling mounted bulkhead light
	Wall mounted bulkhead light
	Strip light

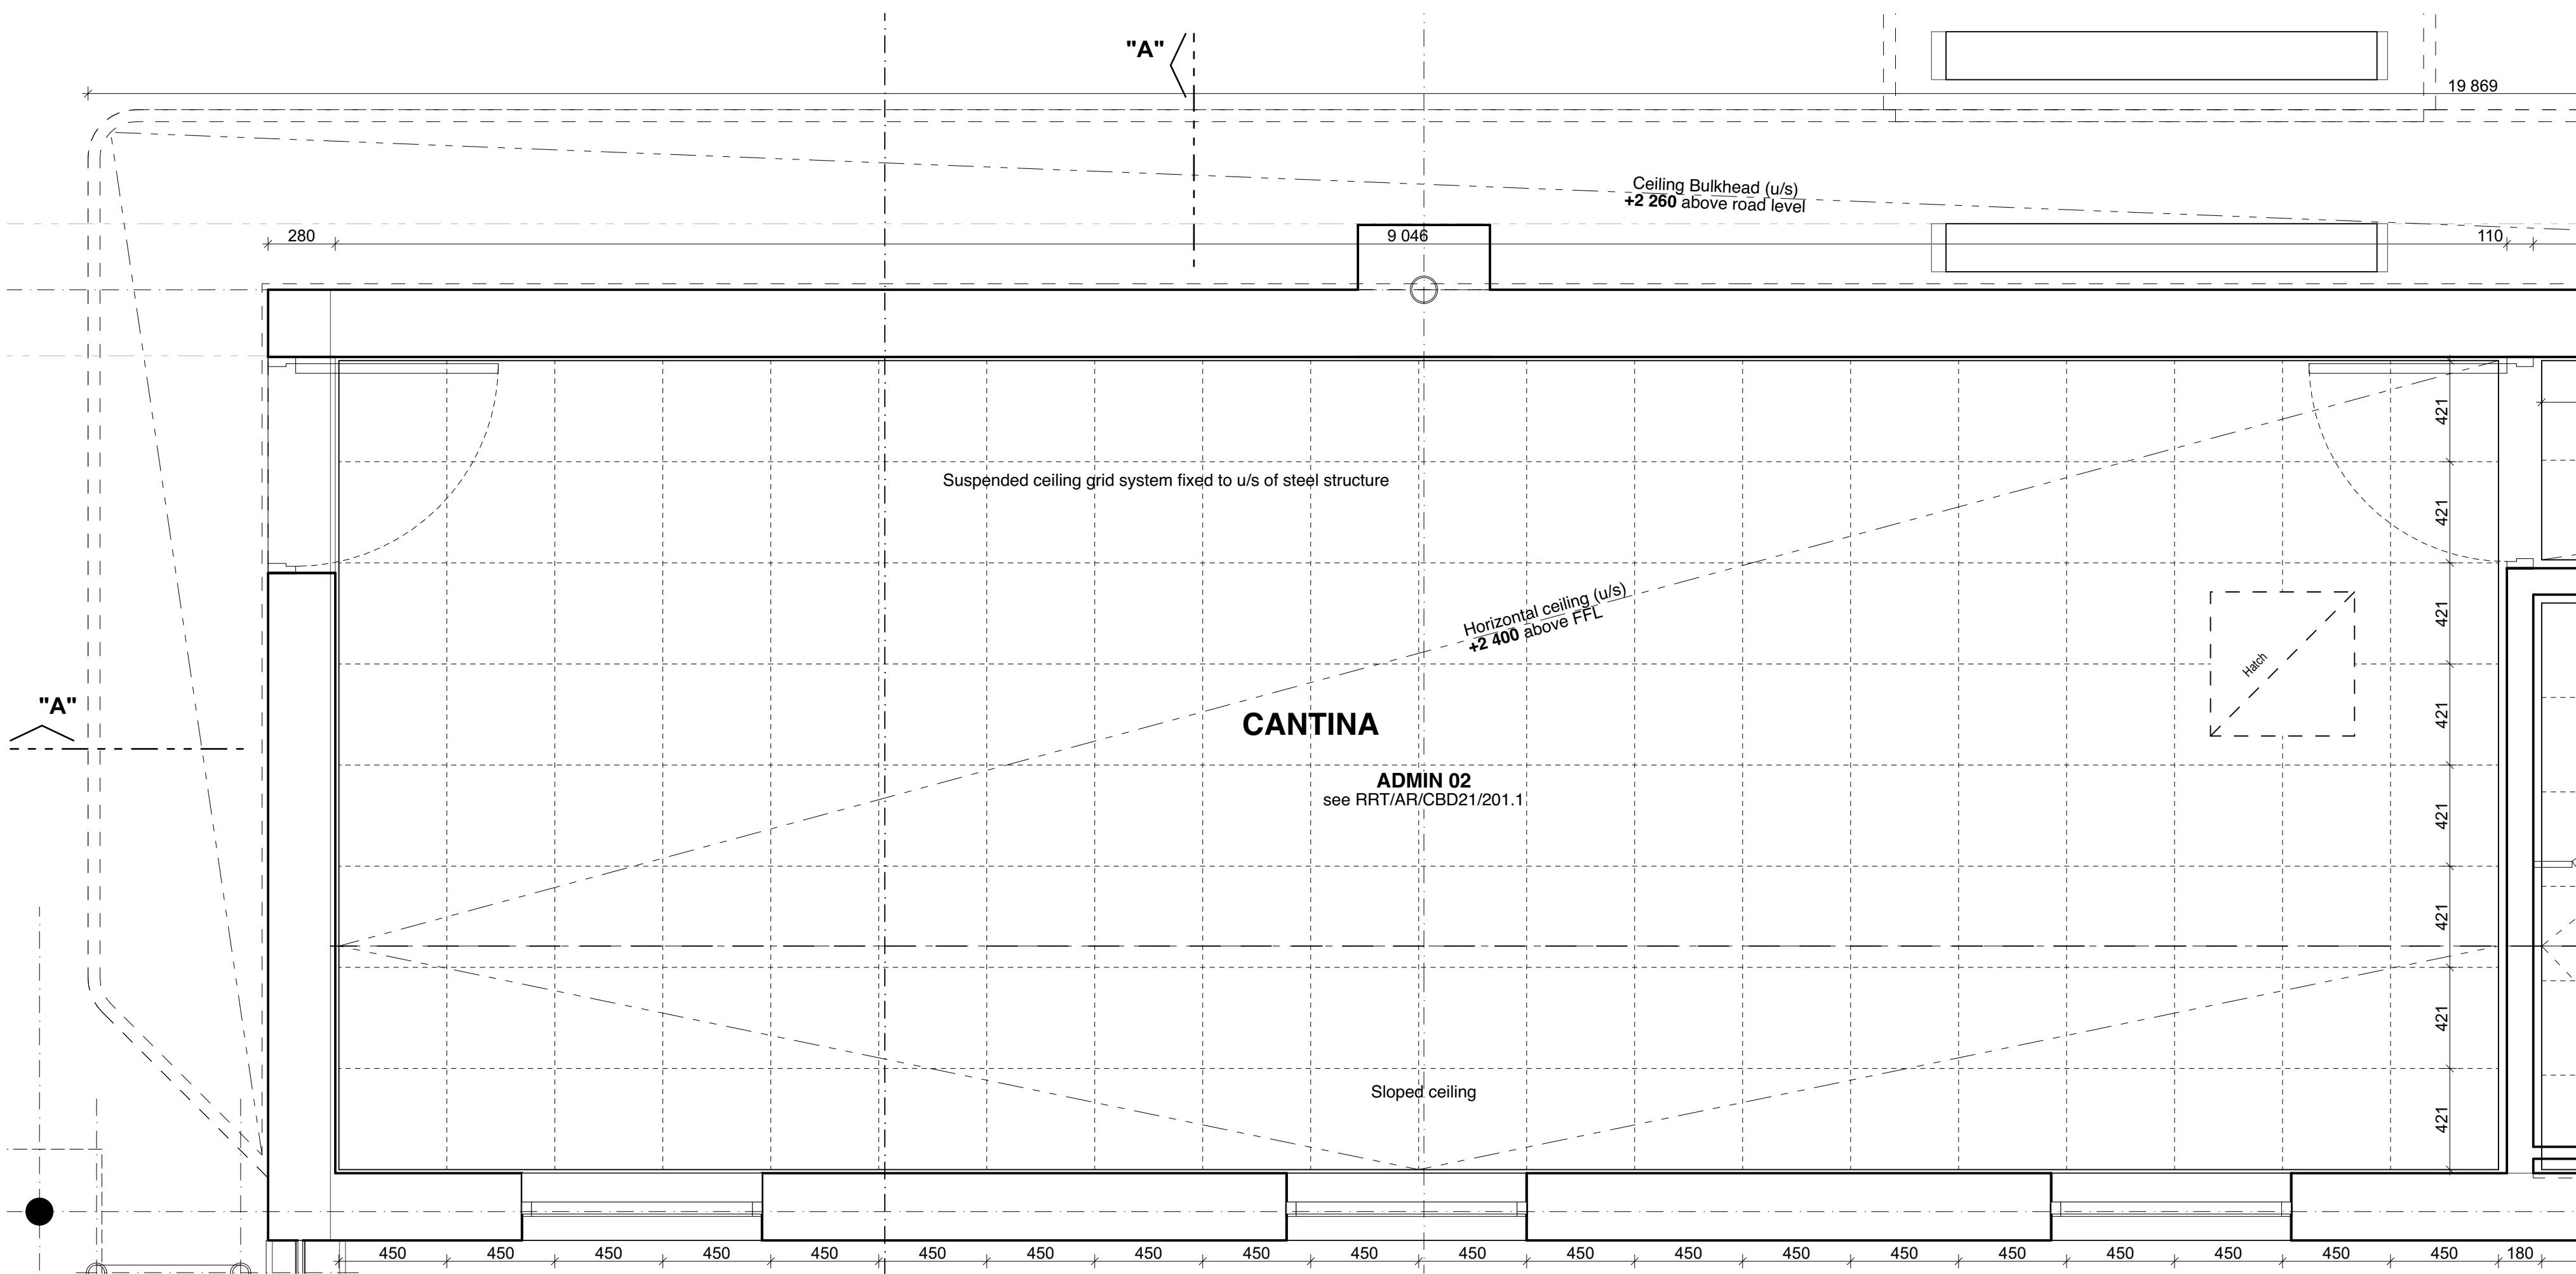


Ceiling Layout

1:20

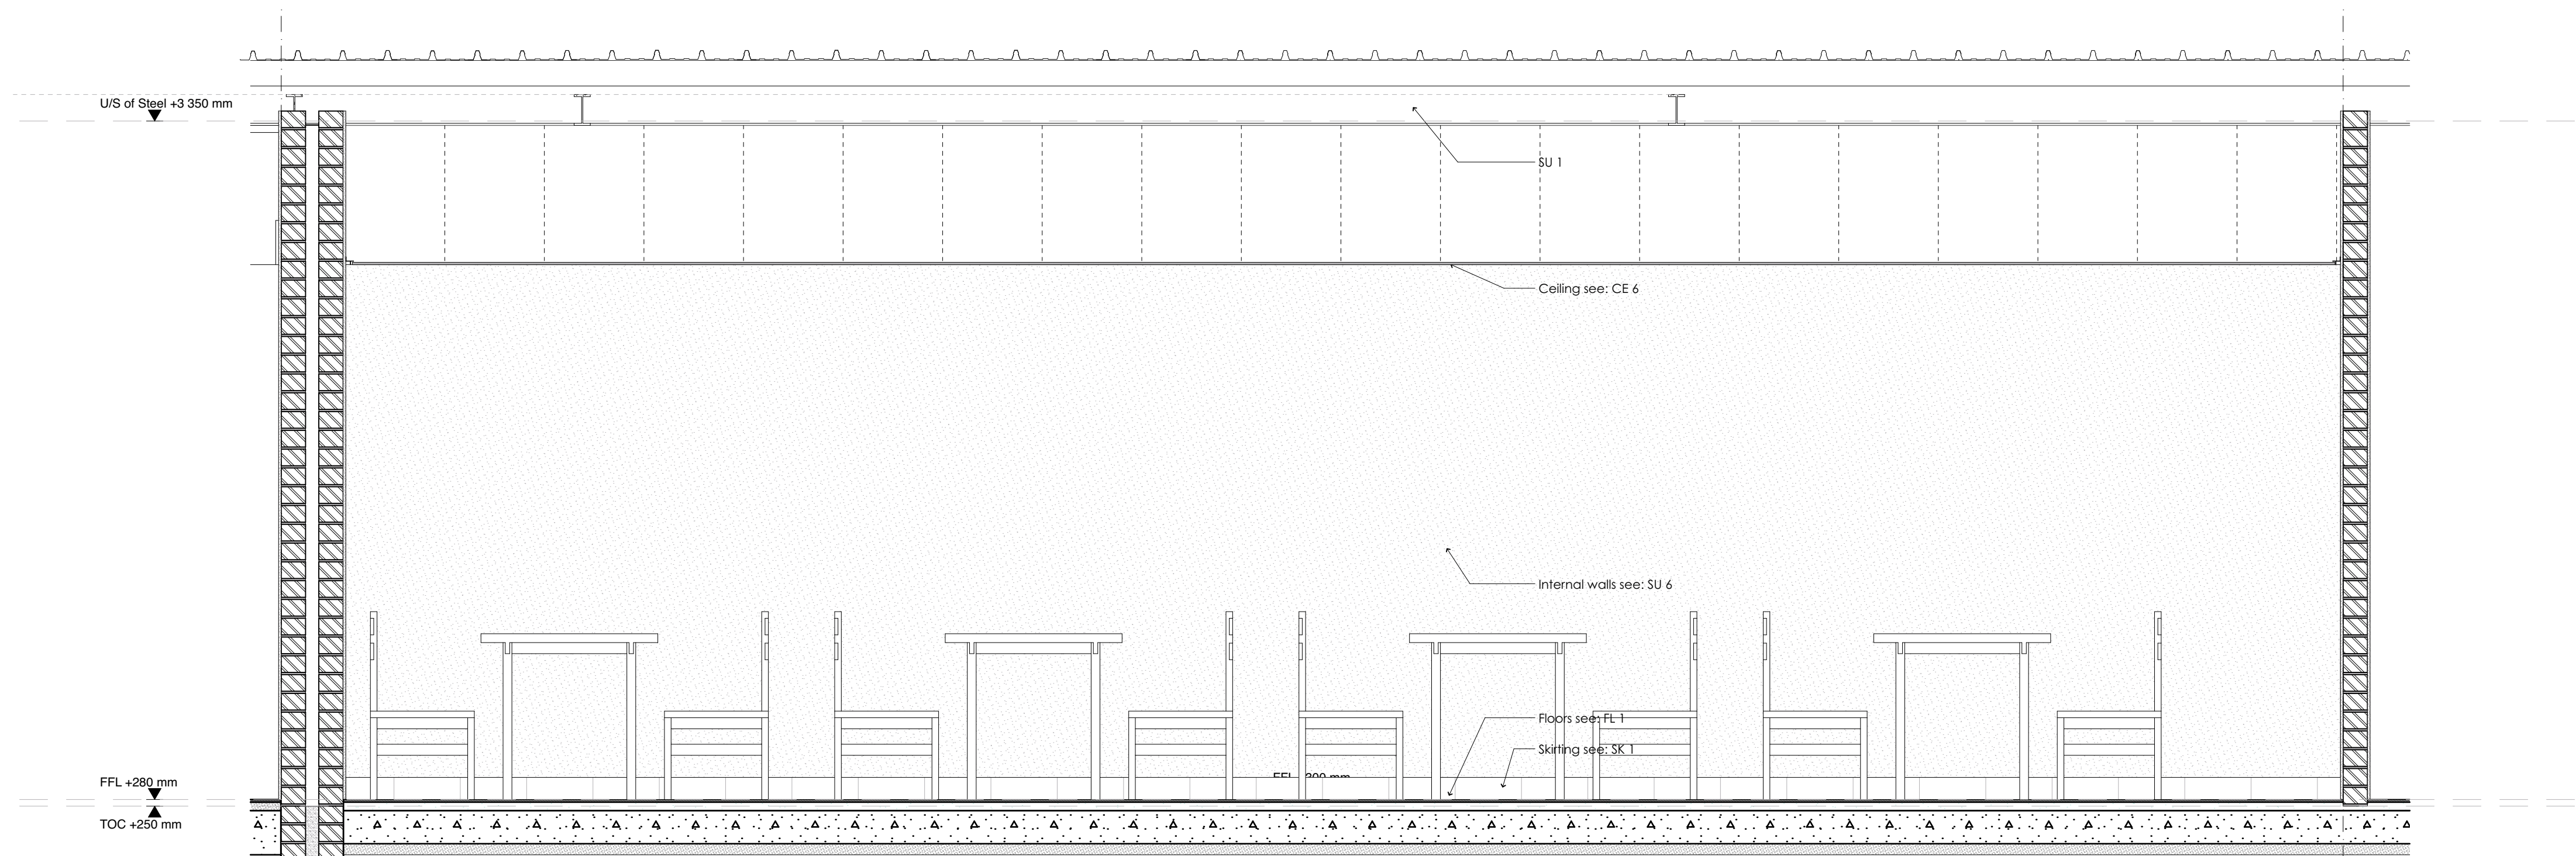

Cantina Elevation 01

1:20

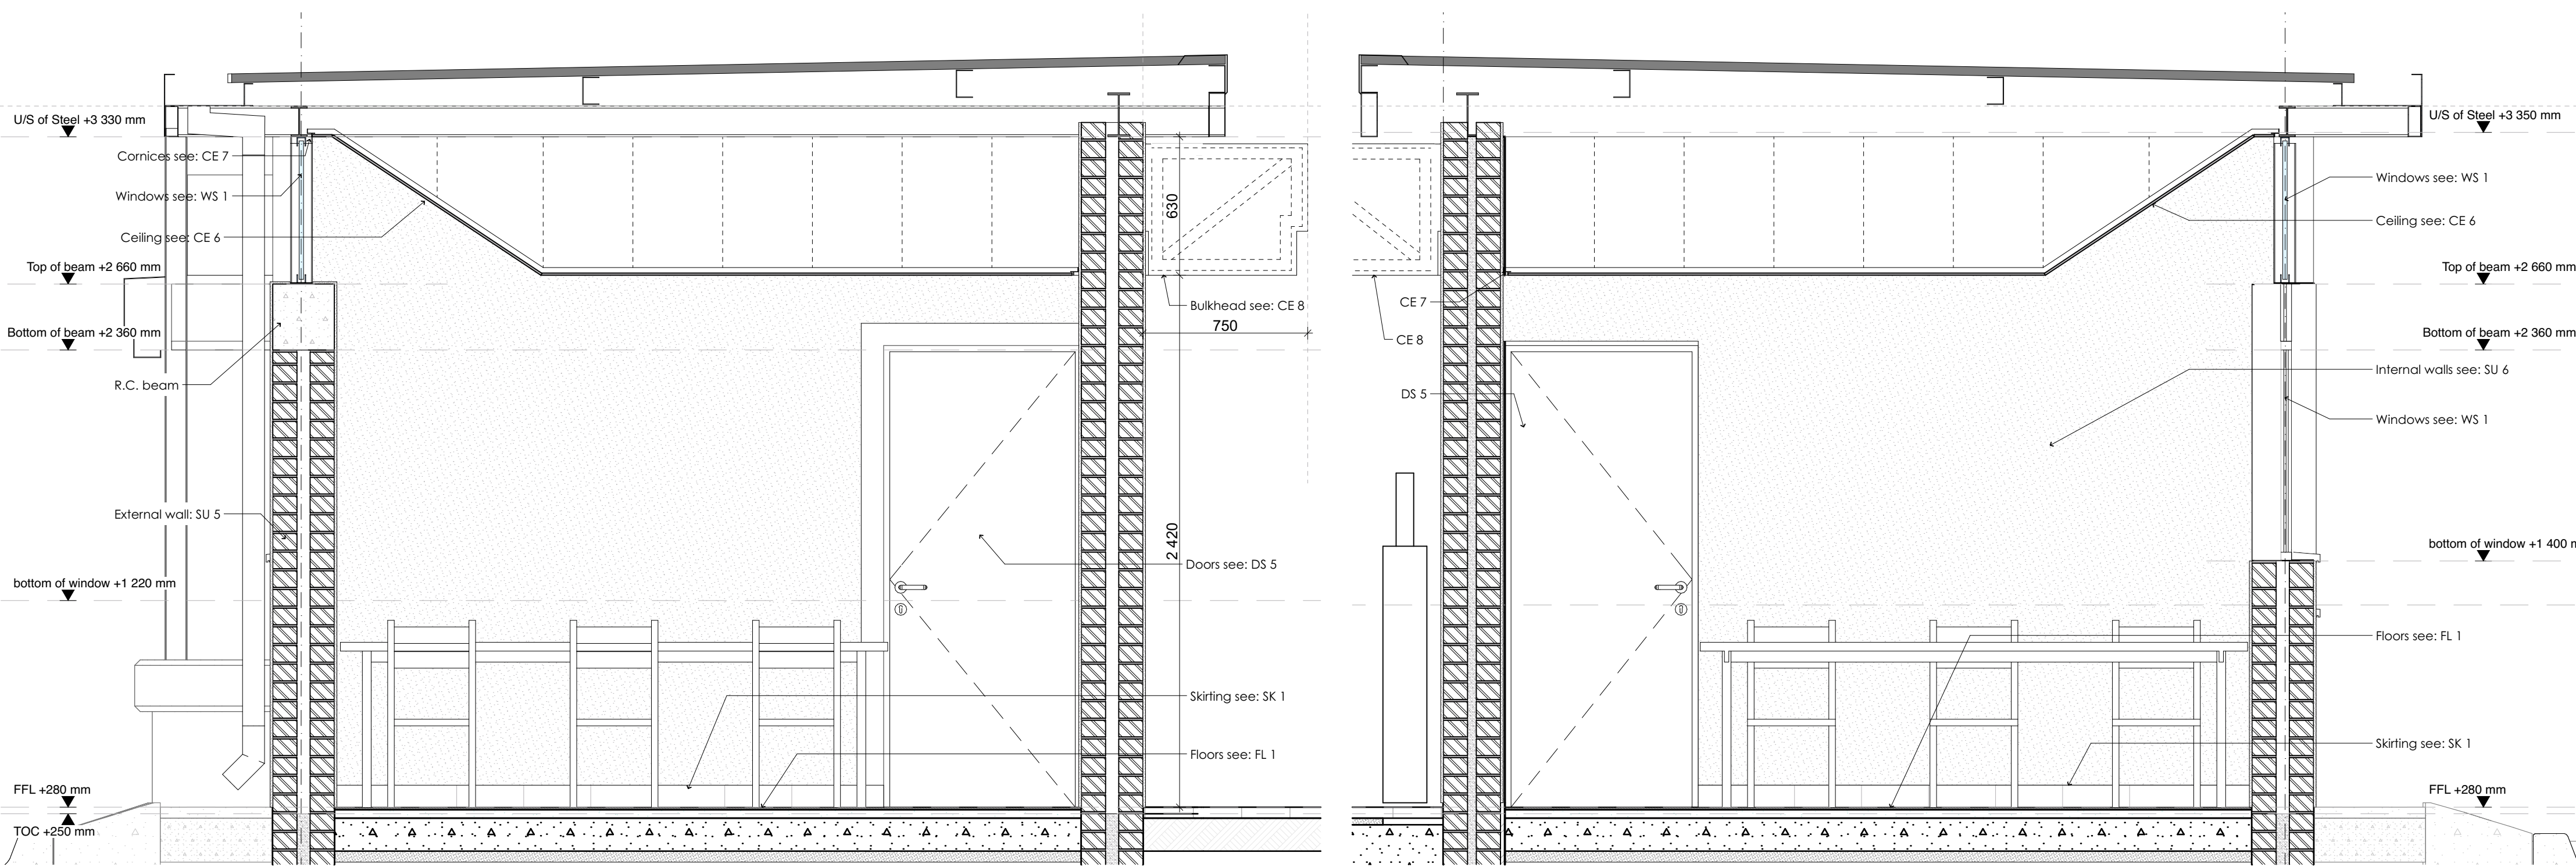


Cantina Elevation 04

1:20

Cantina Elevation 02

1:20

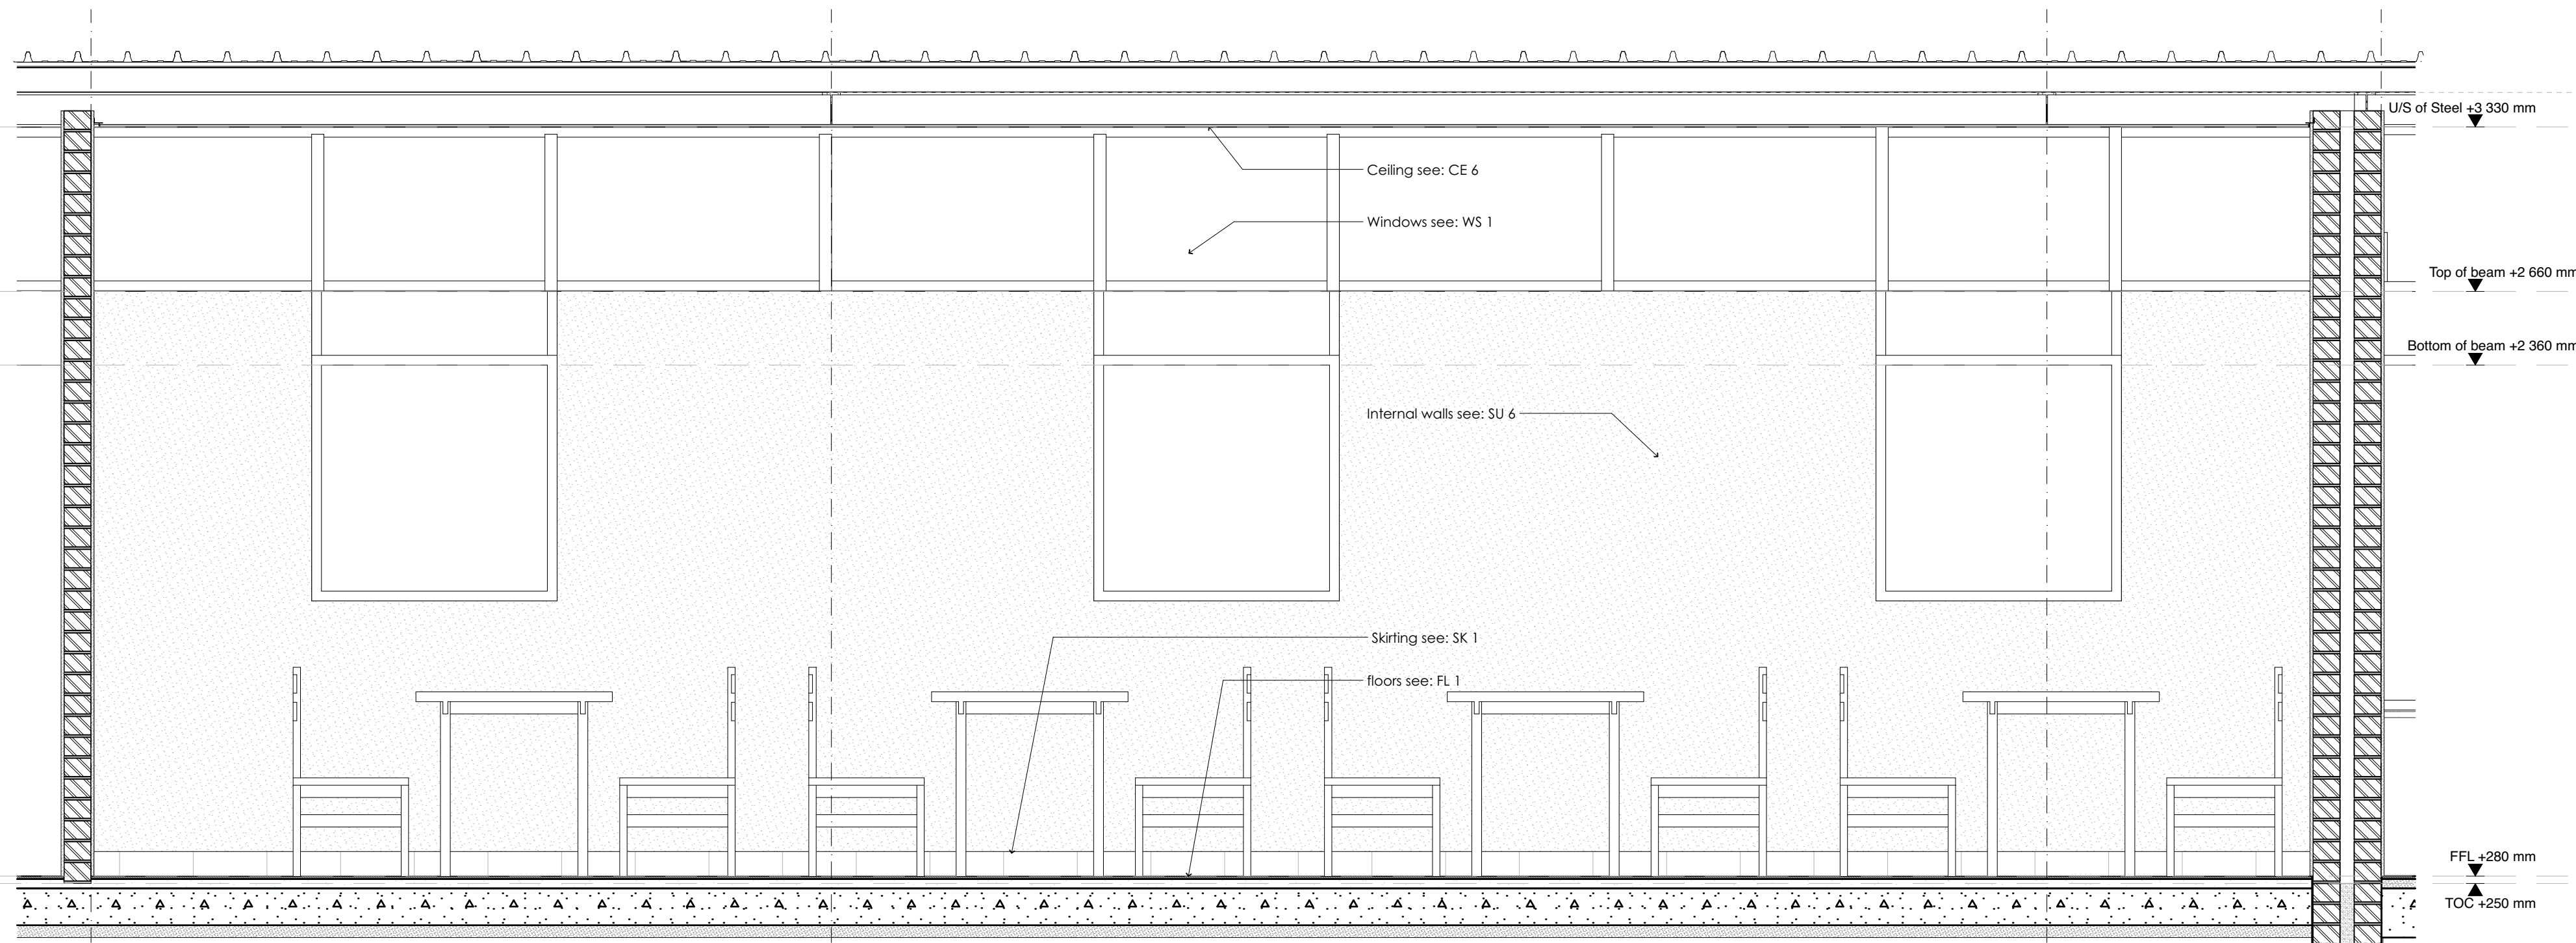

Cantina Elevation 03

1:20

REV	DESCRIPTION	DATE	REV BY	CHKD
CO	FOR CONSTRUCTION	05.02.2018	S	MS
TD	FOR TENDER	02.05.2018	S	MS

DRG. No.	DRAWING TITLE
	ROOM LAYOUT - CANTINA

GENERAL NOTES:
CONTRACTOR: COVER ALL DESIGN AND DRAWINGS SHALL REMAIN THE PROPERTY OF ARG DESIGN AND ANY PROVISION TO THE CONTRARY IN TERMS OF THE CONTRACT ACTUALITY OF THIS IS HEREBY SPECIFICALLY EXCLUDED.
ALL RELEVANT DETAILS, LEVELS AND DIMENSIONS ARE TO BE CHECKED ON SITE PRIOR TO COMMENCEMENT OF WORK. ANY DISCREPANCIES ARE TO BE BROUGHT TO THE ATTENTION OF THE ARCHITECT IMMEDIATELY.
THE ARCHITECT ACCEPTS NO RESPONSIBILITY FOR ERRORS RESULTING FROM MISINTERPRETATION OF THE DRAWINGS.
ALL WORK TO BE CARRIED OUT STRICTLY IN ACCORDANCE WITH NATIONAL BUILDING REGULATIONS SARS 6463 AND LOCAL AUTHORITY REGULATIONS.
ALL DIMENSIONS ARE GIVEN IN MILLIMETERS.
DO NOT SCALE THE DRAWING.

ARCHITECT
arg design
info@argdesign.co.za
www.argdesign.co.za
+27 21 448 2665
central office: 421 main road,
observatory, cape town,
PO box 13606, roosebos 7705

HOLM JORDAAN
ARCHITECTS
5 GARDEN ROAD, 235 HILVERDALE STREET,
NEW MACHESHA, PHUMPA, SOUTH AFRICA
+27 21 448 2000/718
p.j.van.der.stadthoudt@holmjordan.co.za

DESIGNED	INITIALS:	SIGNED:
DRAWN	MS	
CHECKED	IS	
	2C	

PROJECT
RUSTENBURG RAPID TRANSPORT

CLIENT
RUSTENBURG LOCAL MUNICIPALITY

STATION TYPE

PROJECT TITLE
CONSTRUCTION of RUSTENBURG RAPID TRANSPORT (RRT) STATION SUPERSTRUCTURES
ZONE C - CBD
"CBD" - STATION 21 (CENTRAL STATION)

AS BUILT PLAN
(Full signature)

SCALE	SHEET	SIZE
1:20, 1:50		A0 (1189x841)
TENDER No.	PROJECT No.	
RLM/DRT/0124/2017/18	0368	
DRAWING No.	REV	
RRT-AR-CBD21-404-8-C0	0	